
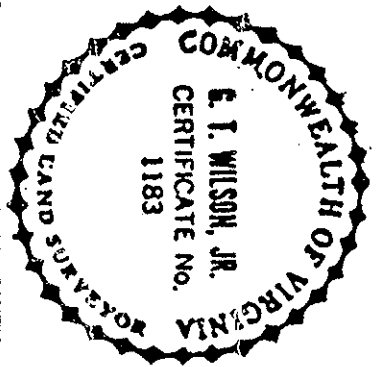



LOT 7 CONTAINS 1 PIPE FOUND

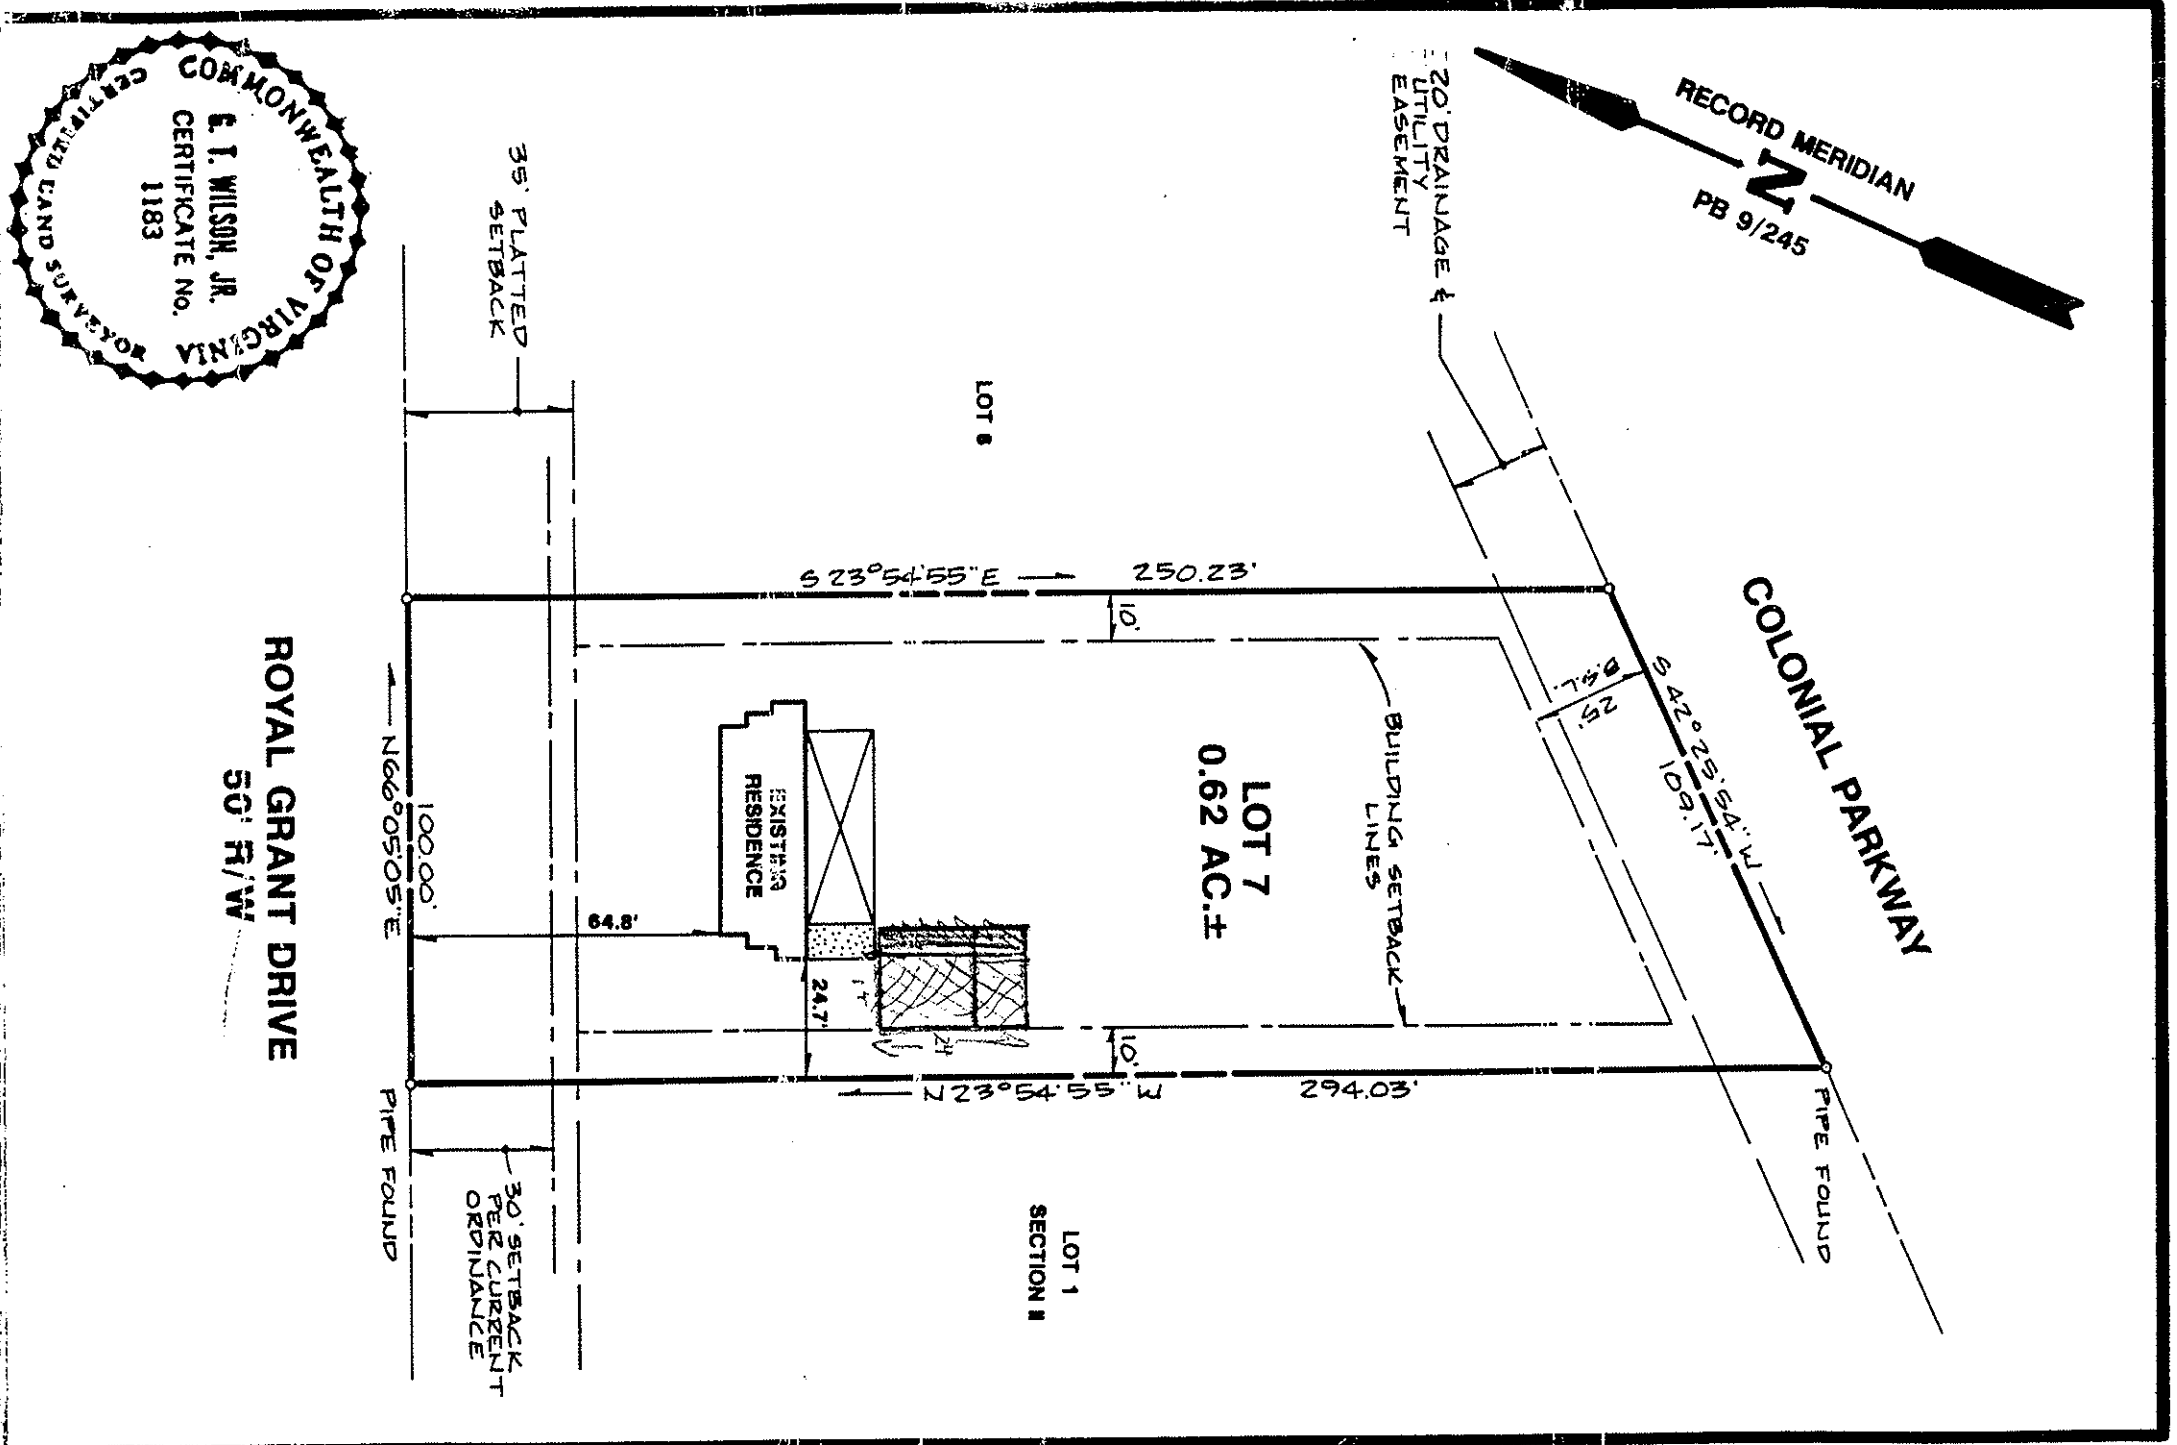

Consulting Engineers Engineers, Surveyors, Planners Williamsburg, Virginia

AS-BUILT SURVEY
LOT 7, SECTION I, ROYAL GRANT
PREPARED FOR HURLEY B. HUGHES

BRUTON DISTRICT YORK COUNTY VIRGINIA
 Scale: 1" = 40' Ref.: PB 9/245 Date: 2/3/94 Job No.: 22347

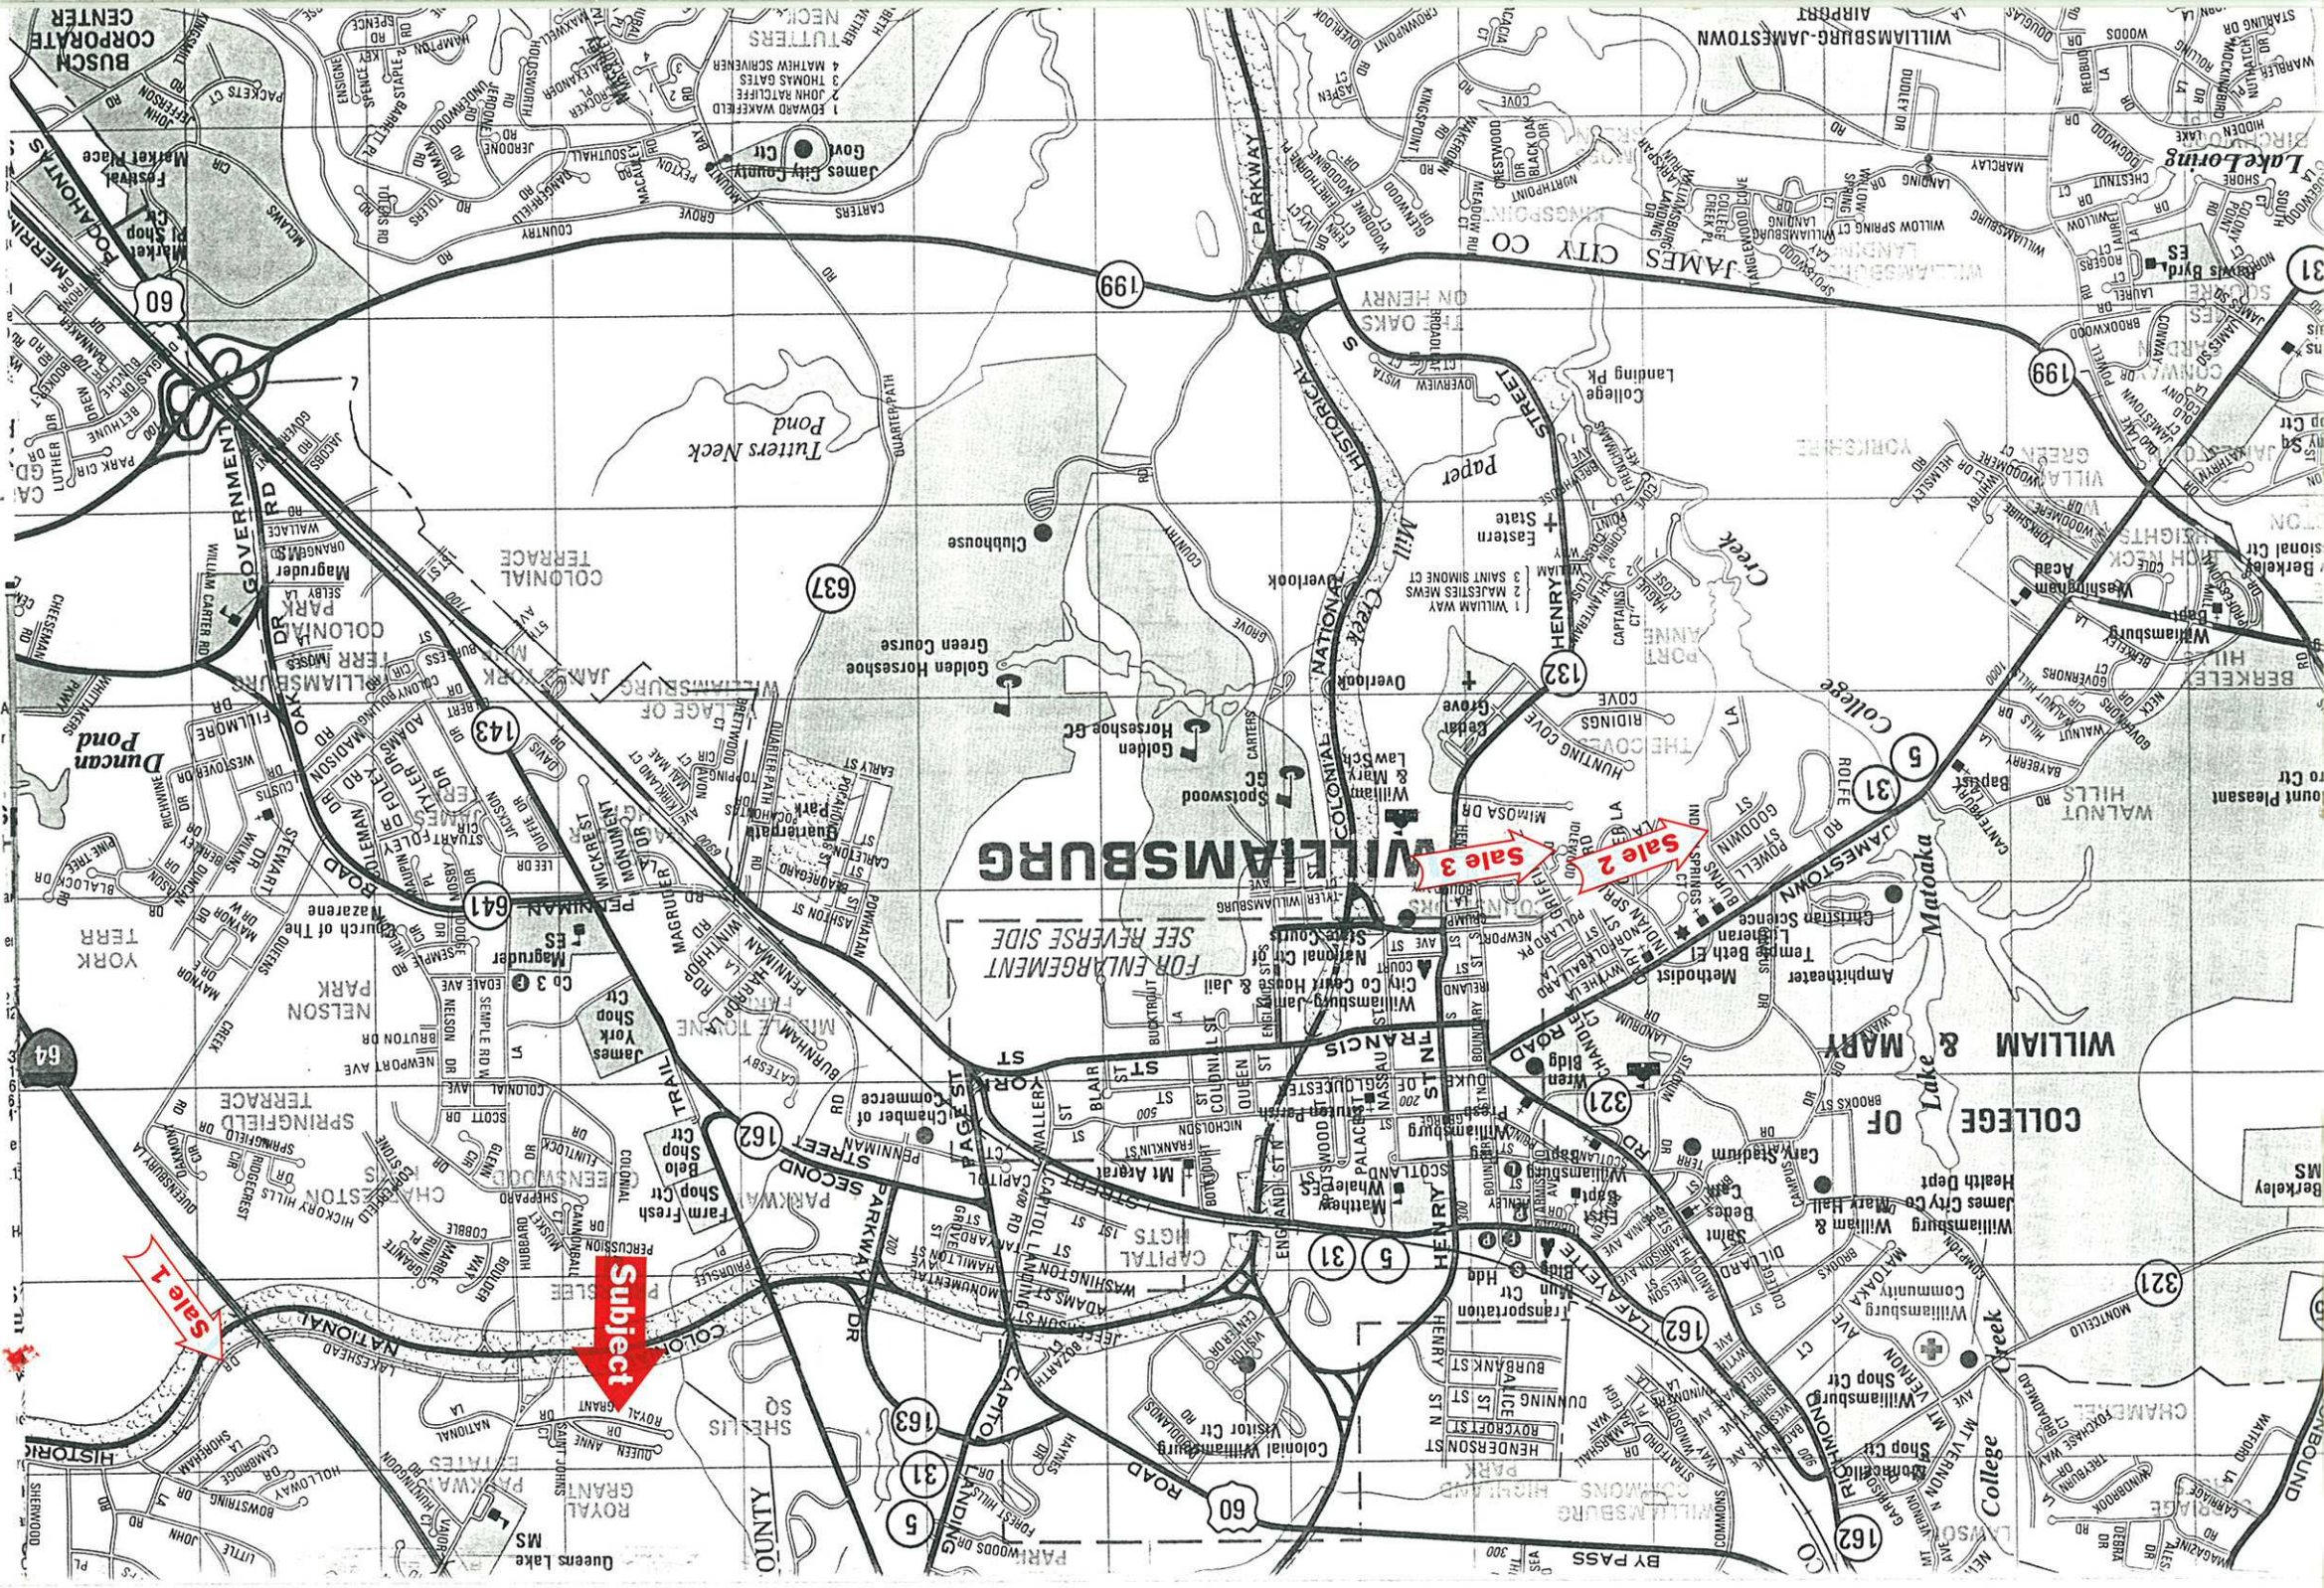

SALE 1

SALE 2

SALE 3

SUBJECT

FOR ENLARGEMENT
SEE REVERSE SIDE

WILLIAMSBURG

Map labels include: James City County, James City College, Williamsburg, Colonial National Parkway, James City Courthouse, James City College, James City High School, James City Junior High School, James City Elementary School, James City Middle School, James City Senior High School, James City Community Center, James City Public Library, James City Art Museum, James City Historical Society, James City Chamber of Commerce, James City Economic Development Corporation, James City Planning Commission, James City Board of Public Works, James City Board of Health, James City Board of Education, James City Board of Police and Fire Commissioners, James City Board of Zoning and Planning, James City Board of Appeals, James City Board of Civil Service, James City Board of Ethics, James City Board of Public Safety, James City Board of Public Utilities, James City Board of Public Works, James City Board of Health, James City Board of Education, James City Board of Police and Fire Commissioners, James City Board of Zoning and Planning, James City Board of Appeals, James City Board of Civil Service, James City Board of Ethics, James City Board of Public Safety, James City Board of Public Utilities.